




Bestandsplan Strom für Anfrage-ID: 20260611_171854373
GSt. Nr. 4087/1

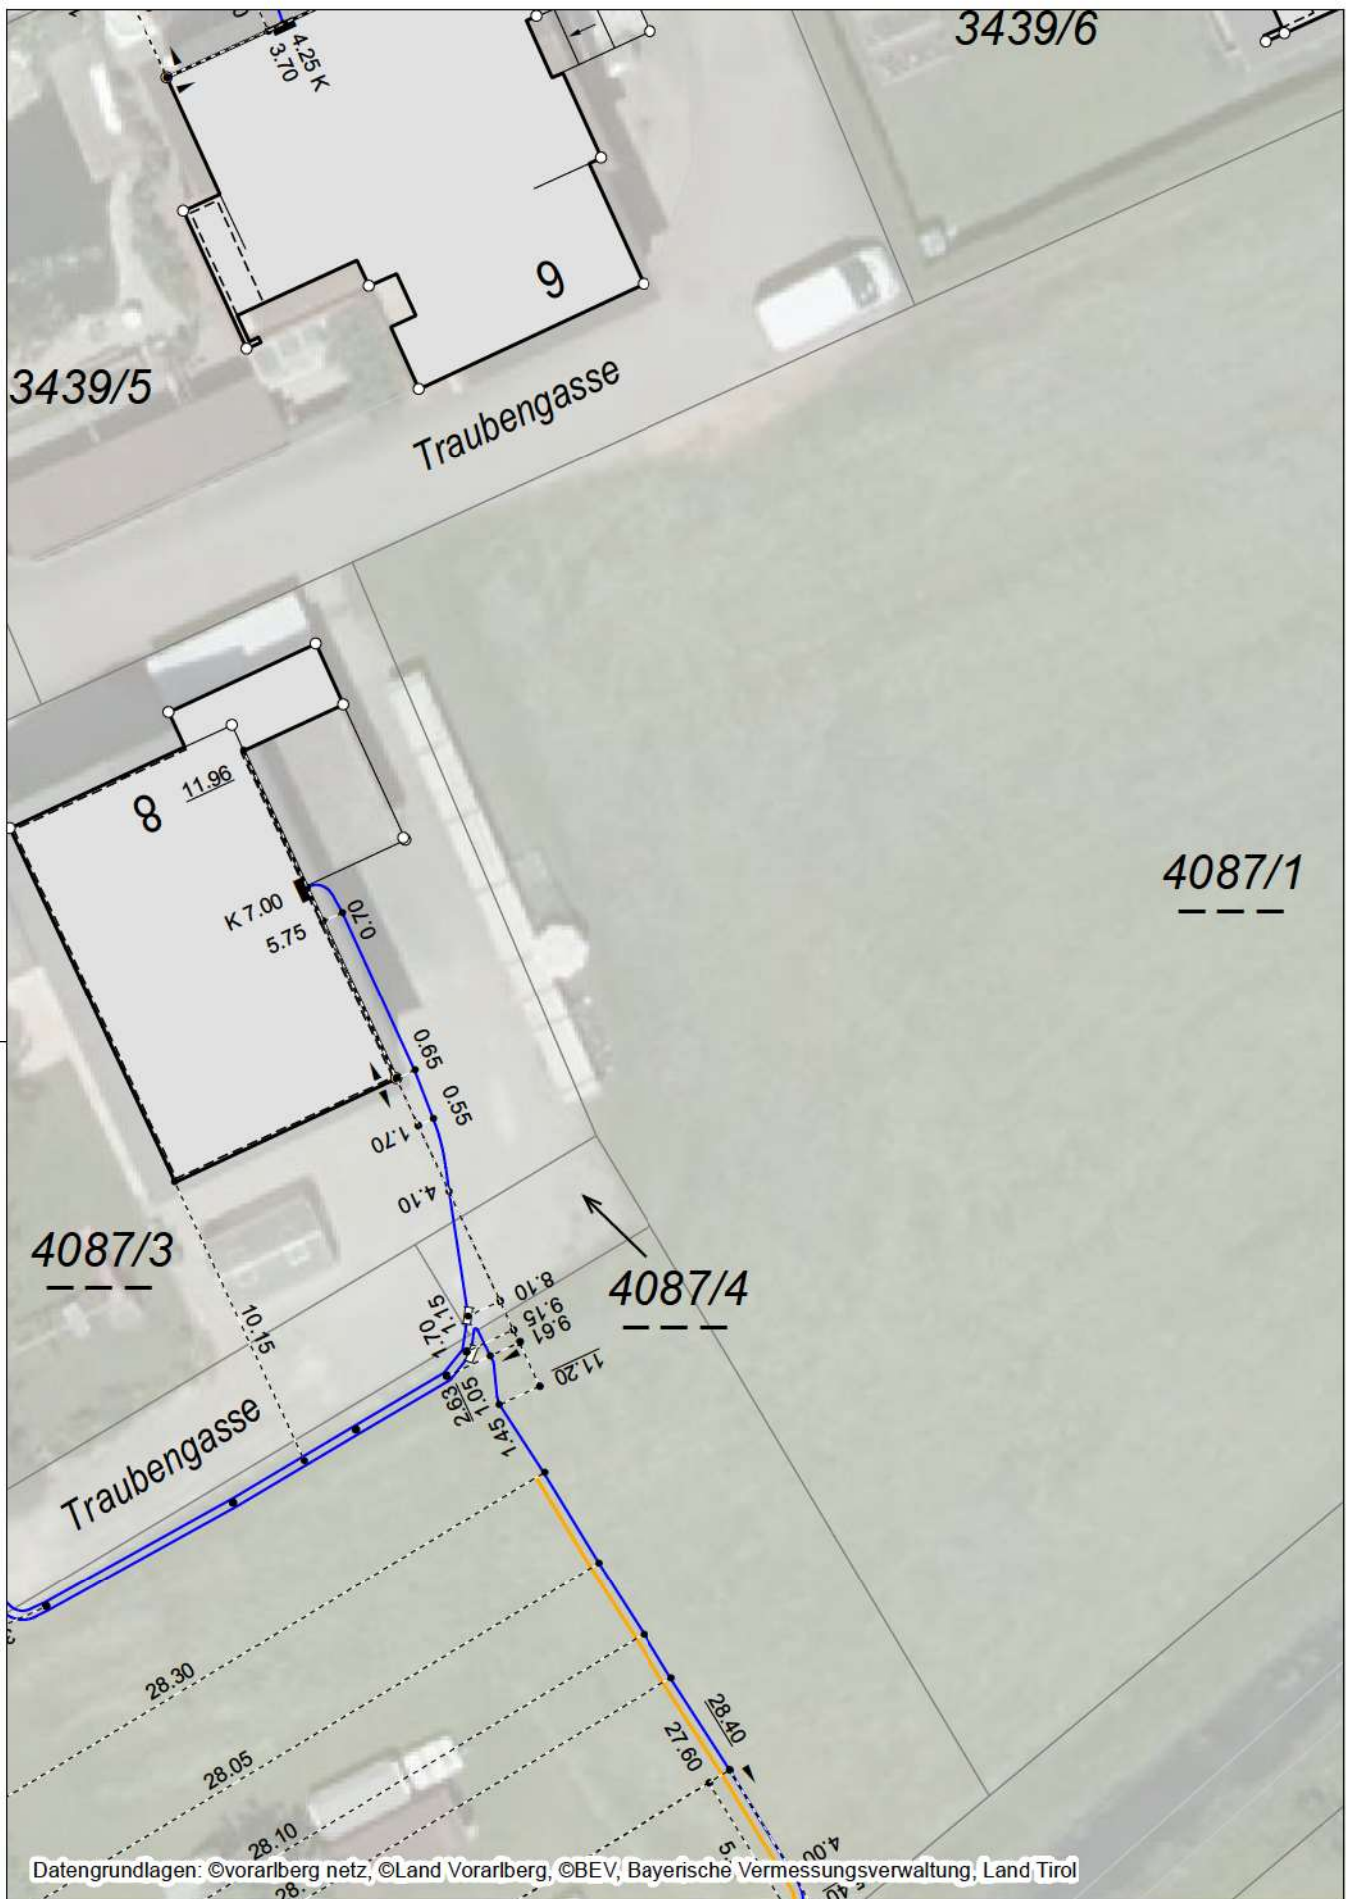